

1     **Re: Page B-140, Construct Diesel Plant Extension, \$176,700**

2     Q.     Please provide a diagram of the layout of the space as it is currently being  
3             used.

4


5

6     A.     See photo below and attached drawing.



NOTE :

1. ALL DIMENSIONS ARE GIVEN IN MILLIMETRES  
UNLESS OTHERWISE INDICATED.

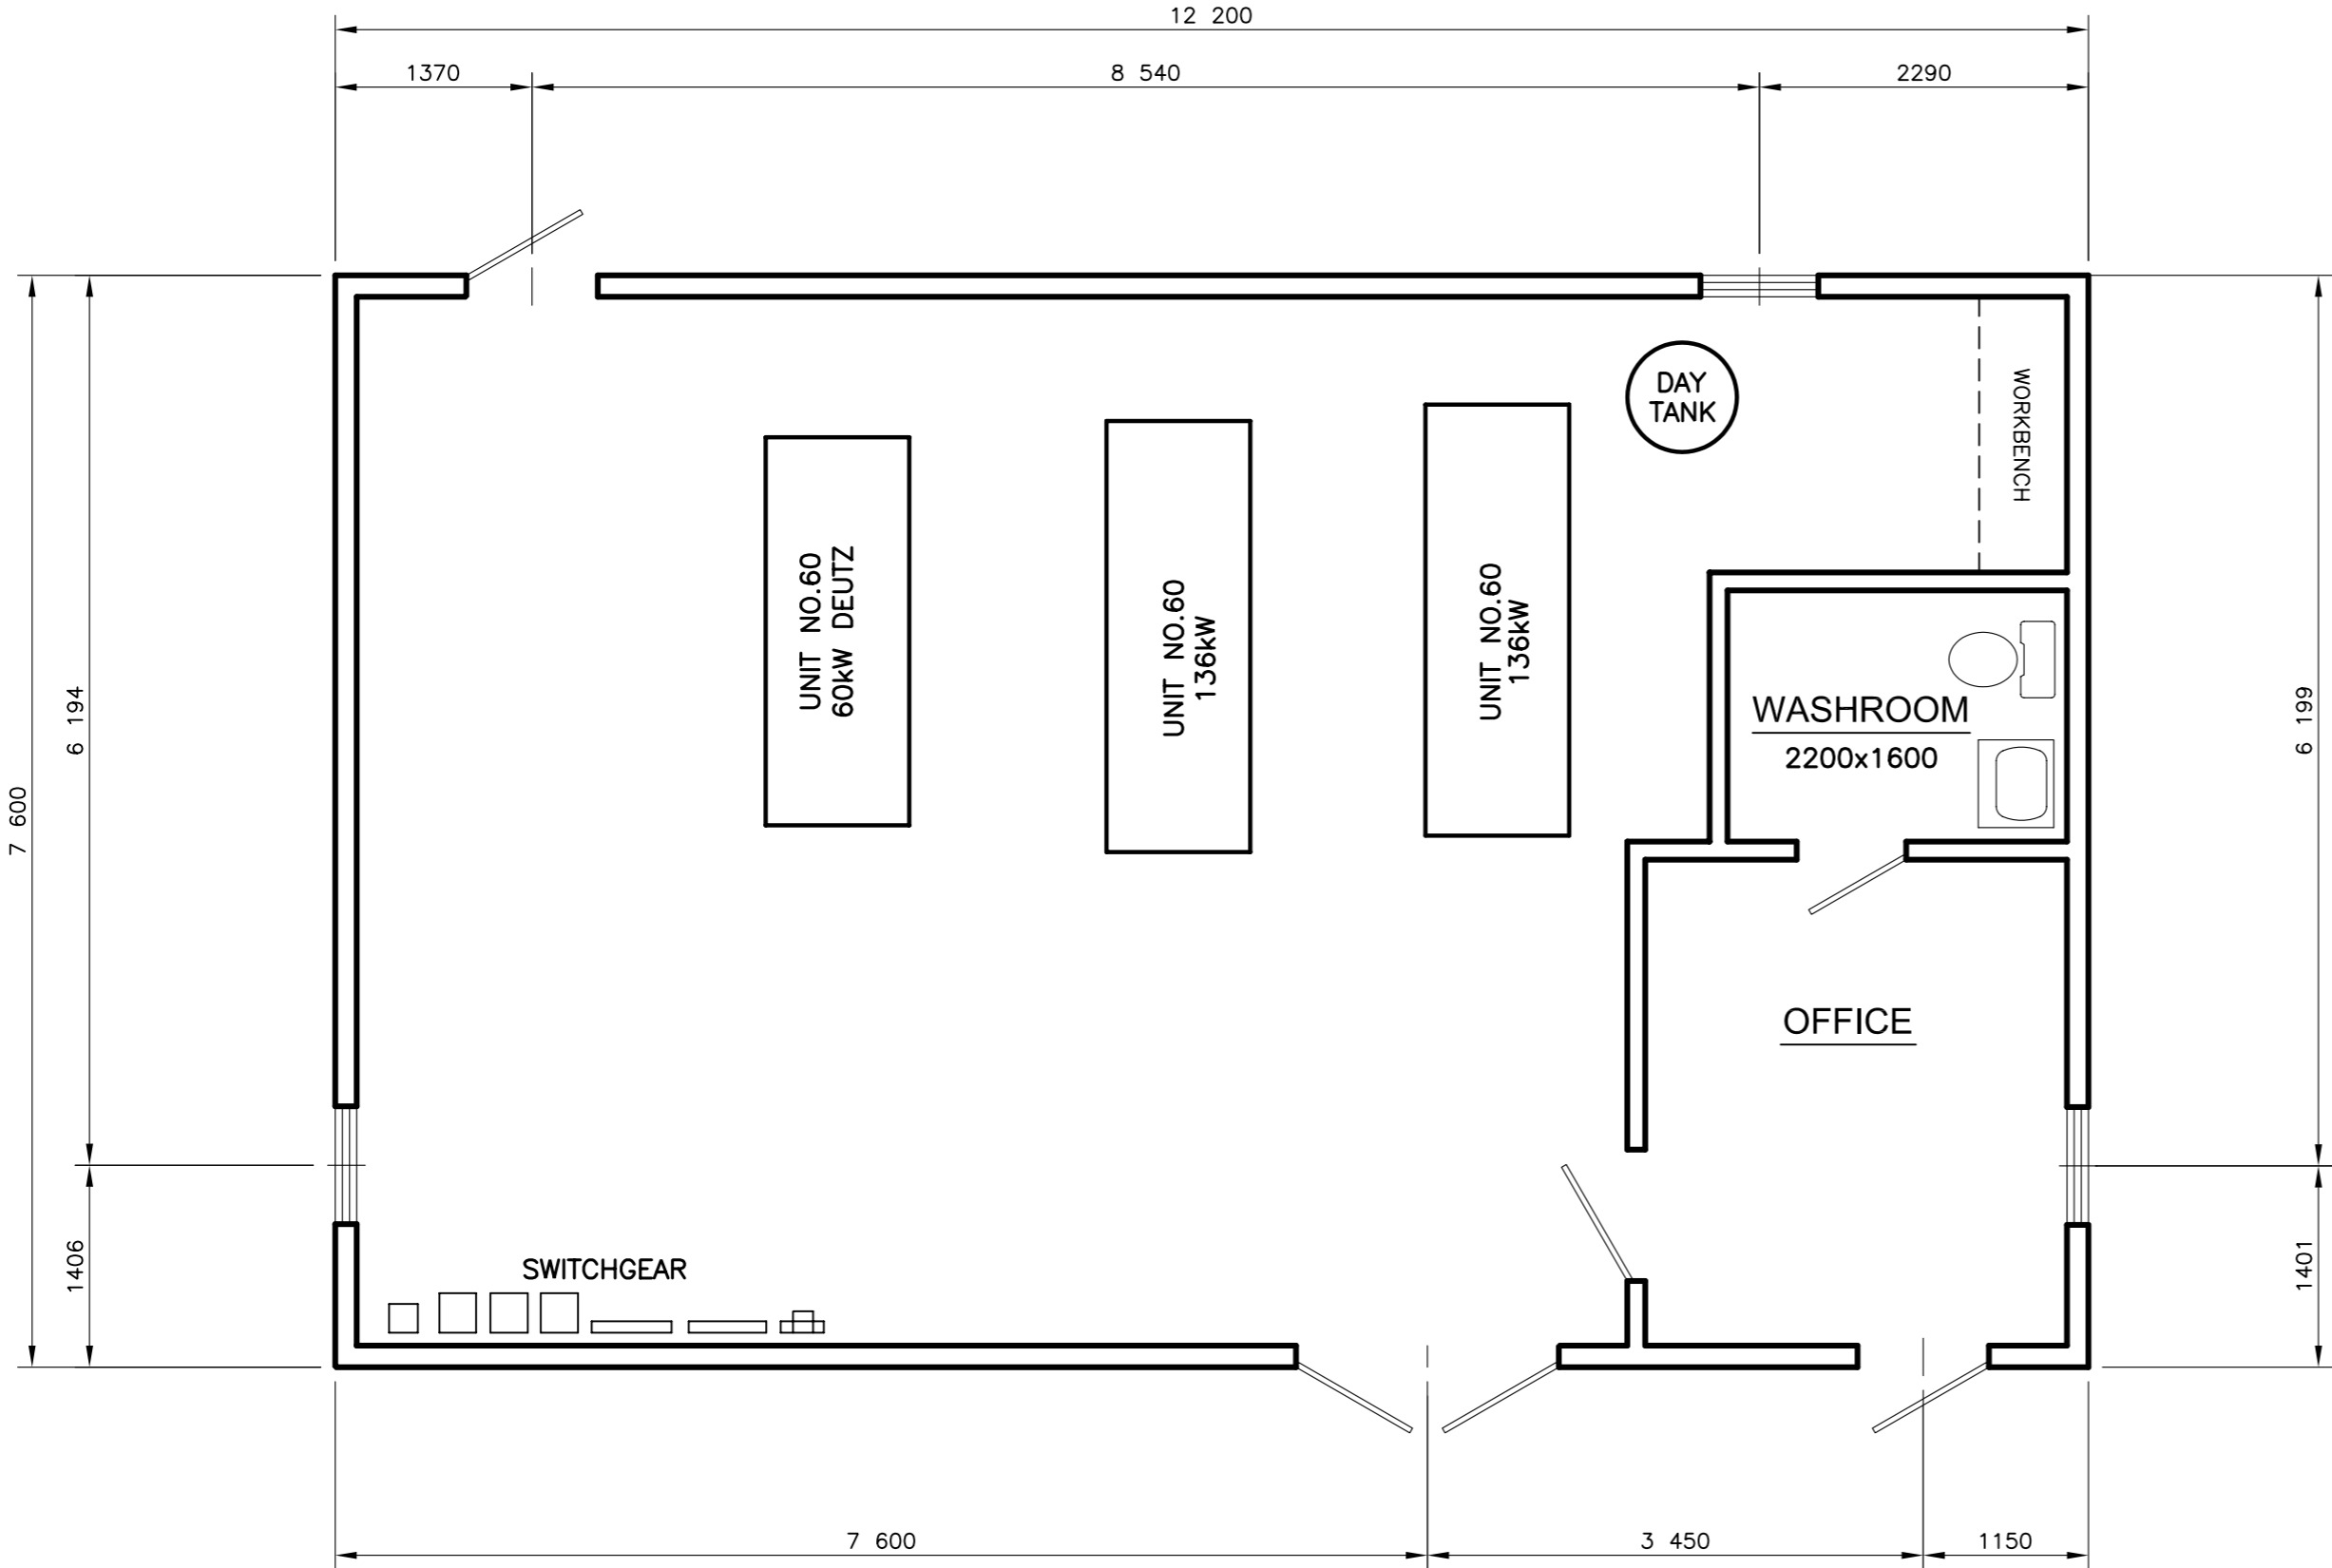

NOTICE:


This Drawing contains intellectual property of Newfoundland and Labrador Hydro (HYDRO) and shall not be copied or distributed in whole or in part without prior written consent from HYDRO. Use of the drawing shall be restricted to purposes of prosecution of a contract with HYDRO.



NEWFOUNDLAND AND LABRADOR HYDRO

2	07-09-19	REVISED AS BUILT	K.B.R	F. REV.			
1	06-03-24	UNIT 2075 ADDED	K.B.R	F. REV.			
NO.	DATE	DESCRIPTION	DWN.	DESIGN.	CHK.	APP'D	

REVISIONS

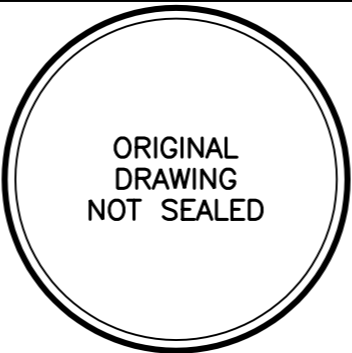

ELECT.	SCALE: 1 : 50
CIVIL	DESIGNED:
TRANS.	DRAWN: K.S.C.
MECH.	DATE: 85-09-09
P&C	CHECKED:
TELC.	APPROVED:

WILLIAMS HARBOUR DIESEL PLANT  
PLANT INTERIOR LAYOUT

W.O.  
NO.

DWG.  
NO.

A2 - 622 - 03 - 06

REV.  
2